REV	DESCRIPTION	DRAWN	DATE
		APPROVED	DATE

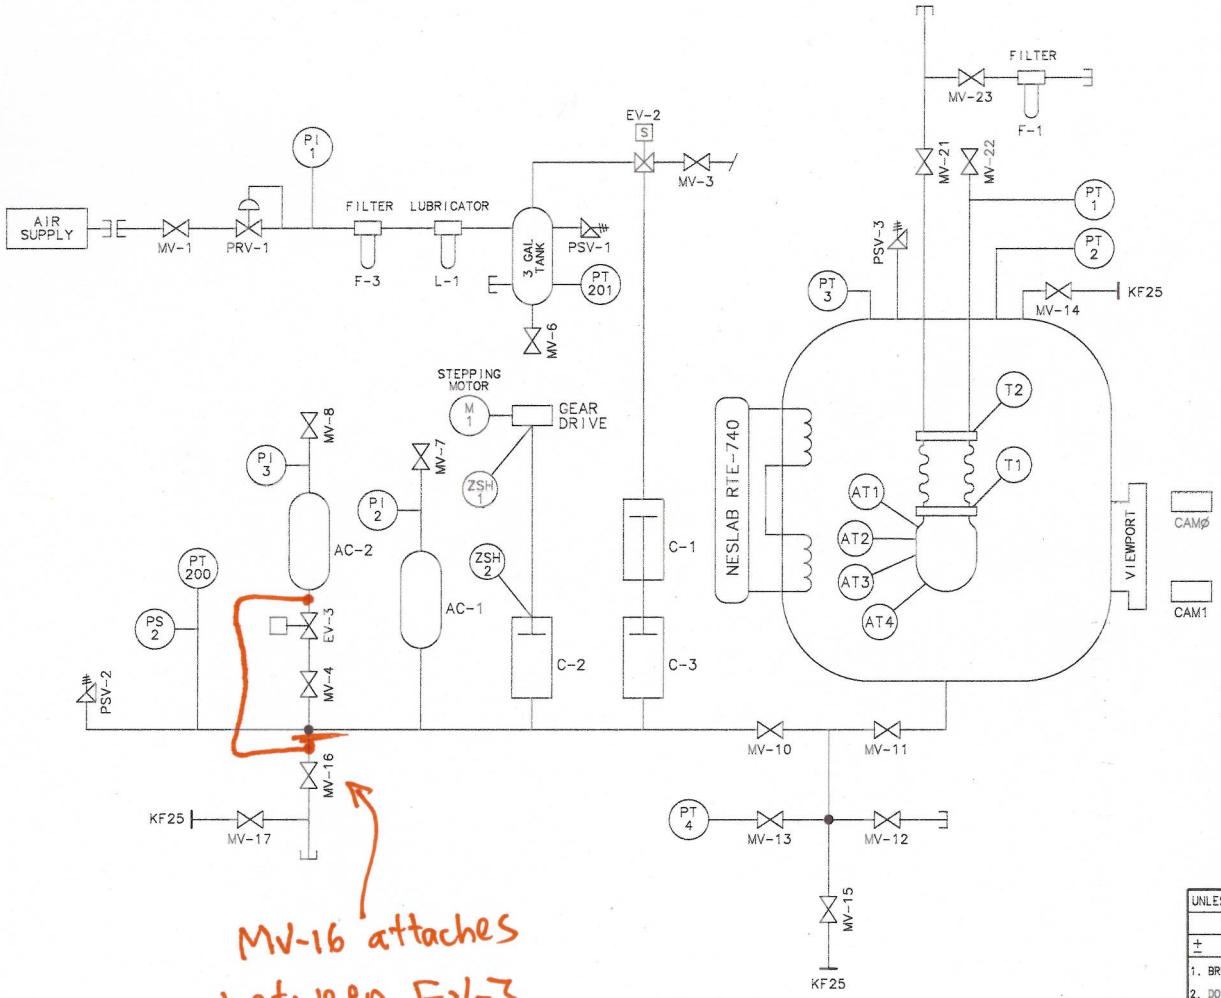

MV-16 attaches between EV-3 and AC-2

not connected at MV-16/MV-4

UNLESS OTHERWISE SPECIFIED	ORIGINATOR	M.CRISLER	29-MAR-2010
	DRAWN	J.CATALANELLO	01-APR-2010
± ± ±	CHECKED		
1. BREAK ALL SHARP EDGES MAX. 2. DO NOT SCALE DRAWING. 3. DIMENSIONS BASED UPON	APPROVED		
4. MAX. ALL MACH. SURFACES	USED ON		
5. DRAWING UNITS:	MATERIAL		

FERMI NATIONAL ACCELERATOR LABORATORY
UNITED STATES DEPARTMENT OF ENERGY

MECHANICAL/DETECTORS
COUPP BUBBLE CHAMBER
COUPP-2L PIPING & INST. DIAGRAM

SCALE	DRAWING NUMBER	SHEET	REV
	9213.400-MC-466868	1 OF 1	

CREATED WITH : Ideas12NXSeries GROUP: PPD/MECHANICAL DEPARTMENT

Created: 06:55:43 on 21-07-10 (D-M-Y) By: catalan State: 1-INITIAL