| REV | DESCRIPTION | DRAWN | DATE |
|---|---|---|---|
| | | APPROVED | DATE |

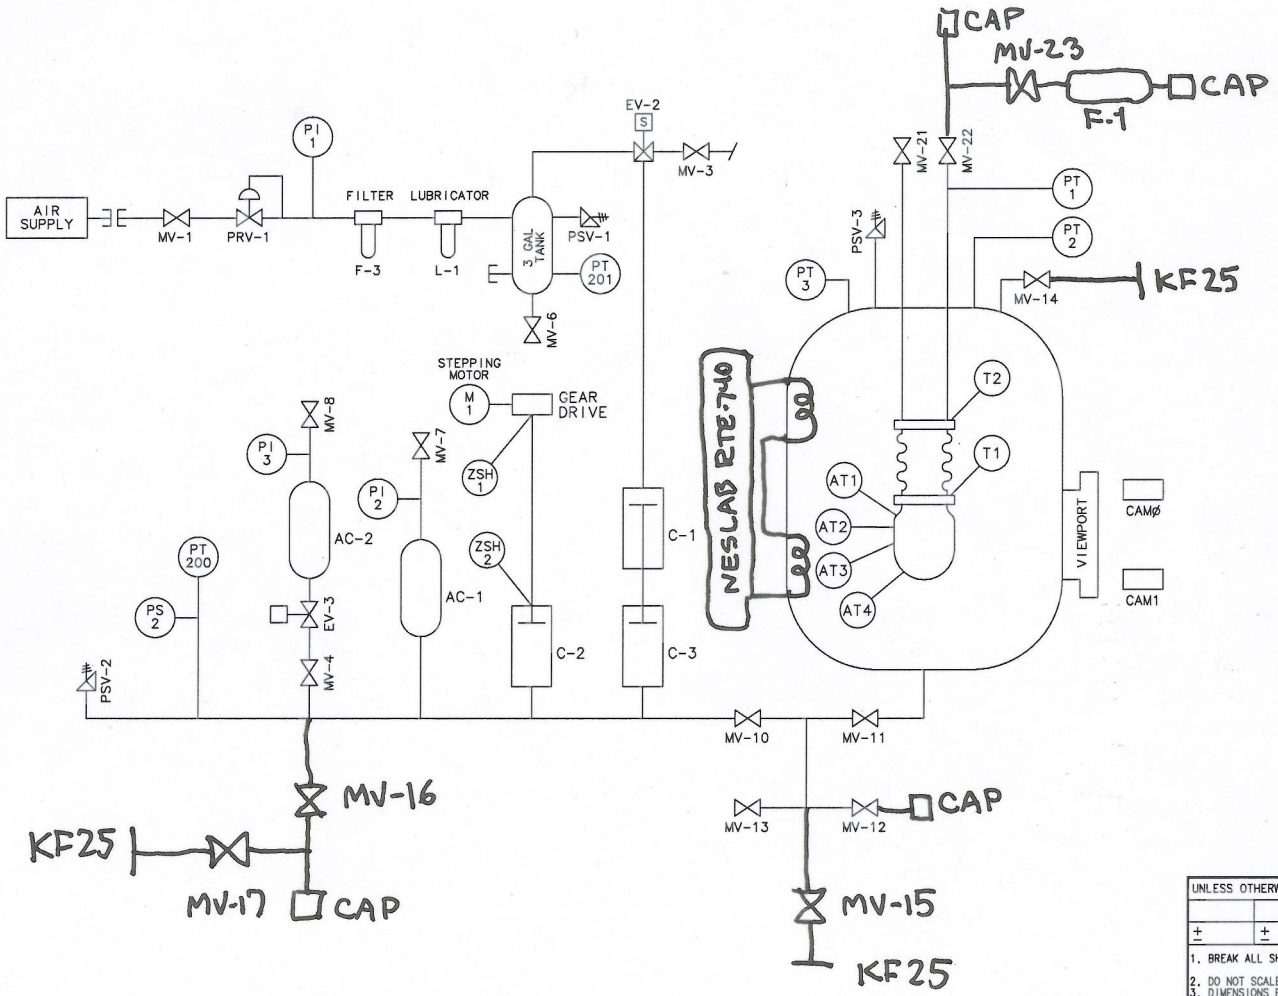


| UNLESS OTHERWISE SPECIFIED | ORIGINATOR | M.CRISLER | 29-MAR-2010 |
|---|---|---|---|
| | DRAWN | J.CATALANELLO | 01-APR-2010 |
| ± ± ± | CHECKED | | |
| 1. BREAK ALL SHARP EDGES MAX. 2. DO NOT SCALE DRAWING. 3. DIMENSIONS BASED UPON | APPROVED | | |
| 4. MAX. ALL MACH. SURFACES ✓ | USED ON | | |
| 5. DRAWING UNITS: | MATERIAL | | |

FERMI NATIONAL ACCELERATOR LABORATORY
UNITED STATES DEPARTMENT OF ENERGY

# MECHANICAL/DETECTORS
# COUPP BUBBLE CHAMBER
# COUPP-2L PIPING & INST. DIAGRAM

| SCALE | DRAWING NUMBER | SHEET | REV |
|---|---|---|---|
| | 9213.400-MC-466868 | 1 OF 1 | |

CREATED WITH : Ideas12NXSeries GROUP: PPD/MECHANICAL DEPARTMENT

Created: 09:45:57 on 07-04-10 (D-M-Y) By: catalan State: 1-INITIAL